




FB. 1488 P. 94 & 95

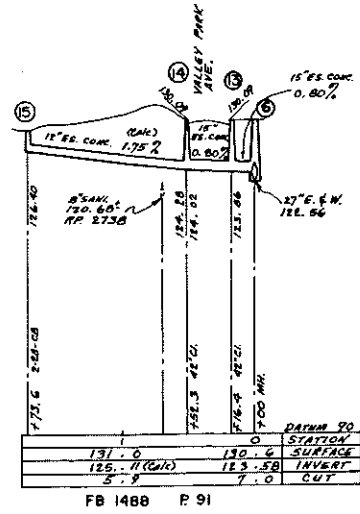


FB. 1488 P. 91

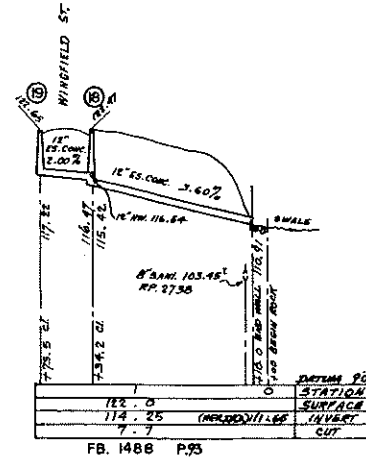


FB. 1488 P. 93

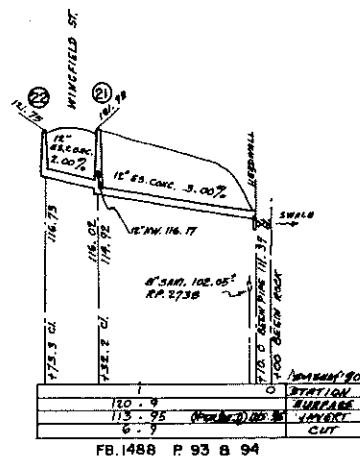



FB. 1488 P. 93 & 94

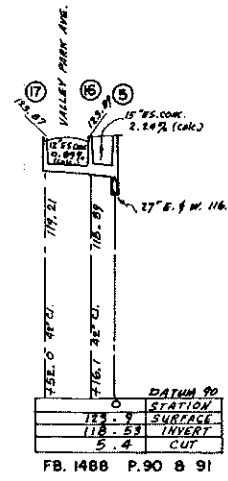

FB. 1488 P. 90 & 91

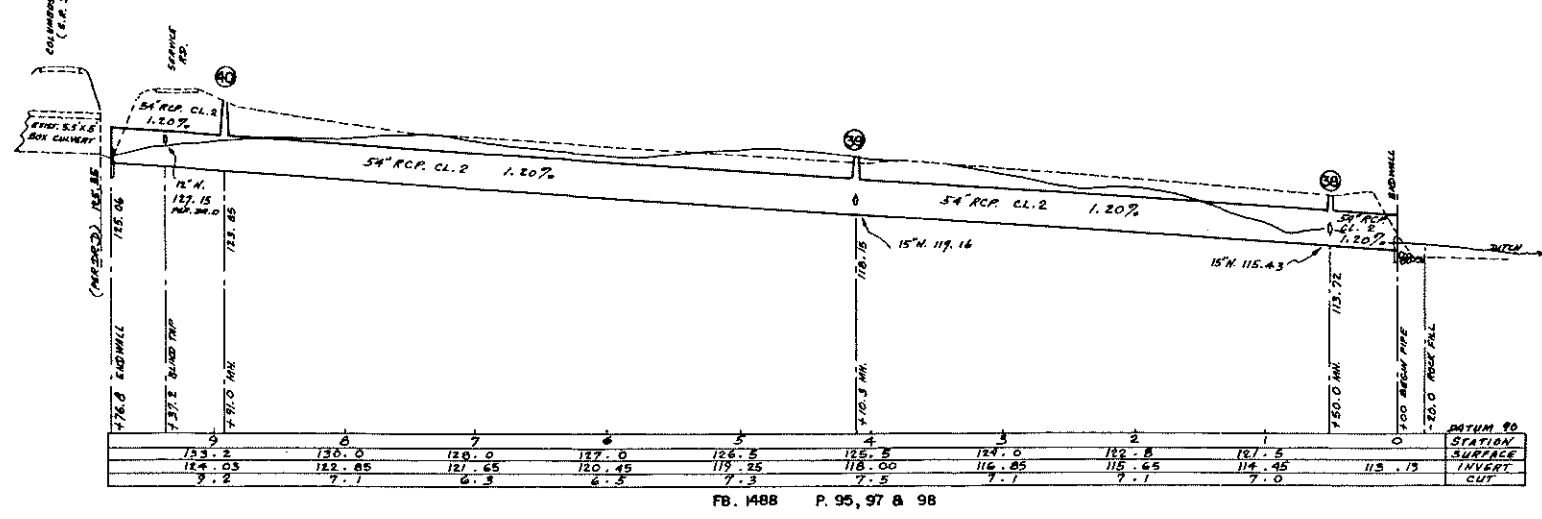



PARKRIDGE VILLAGE

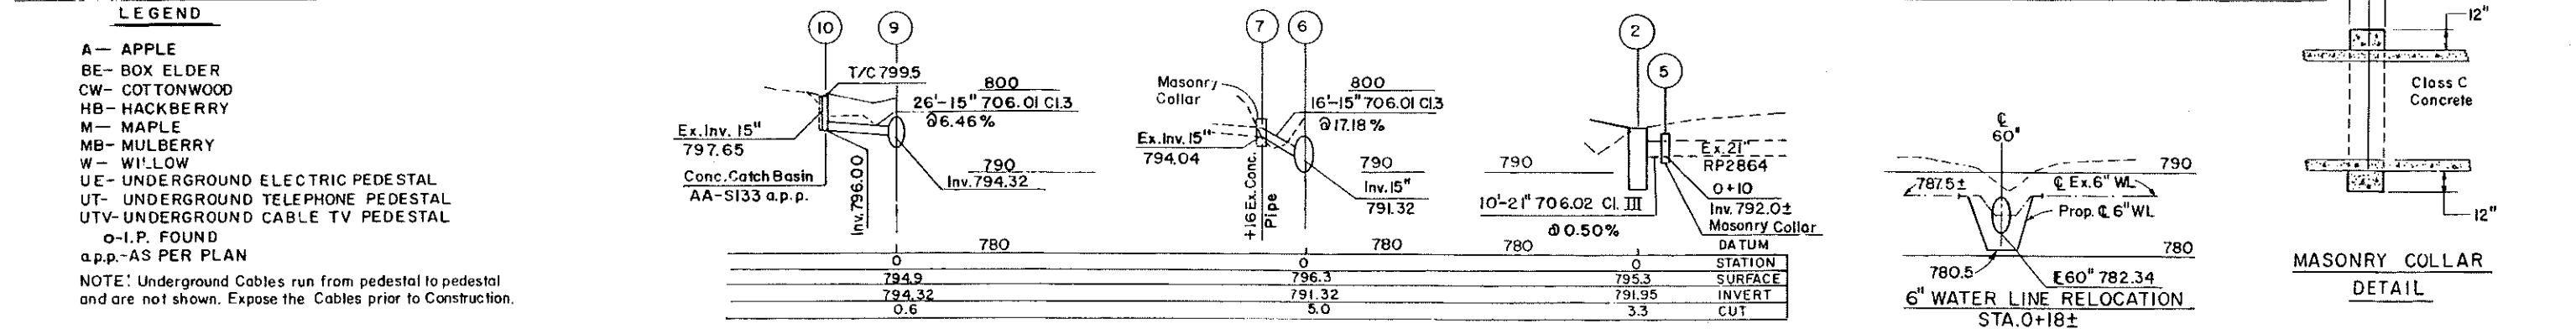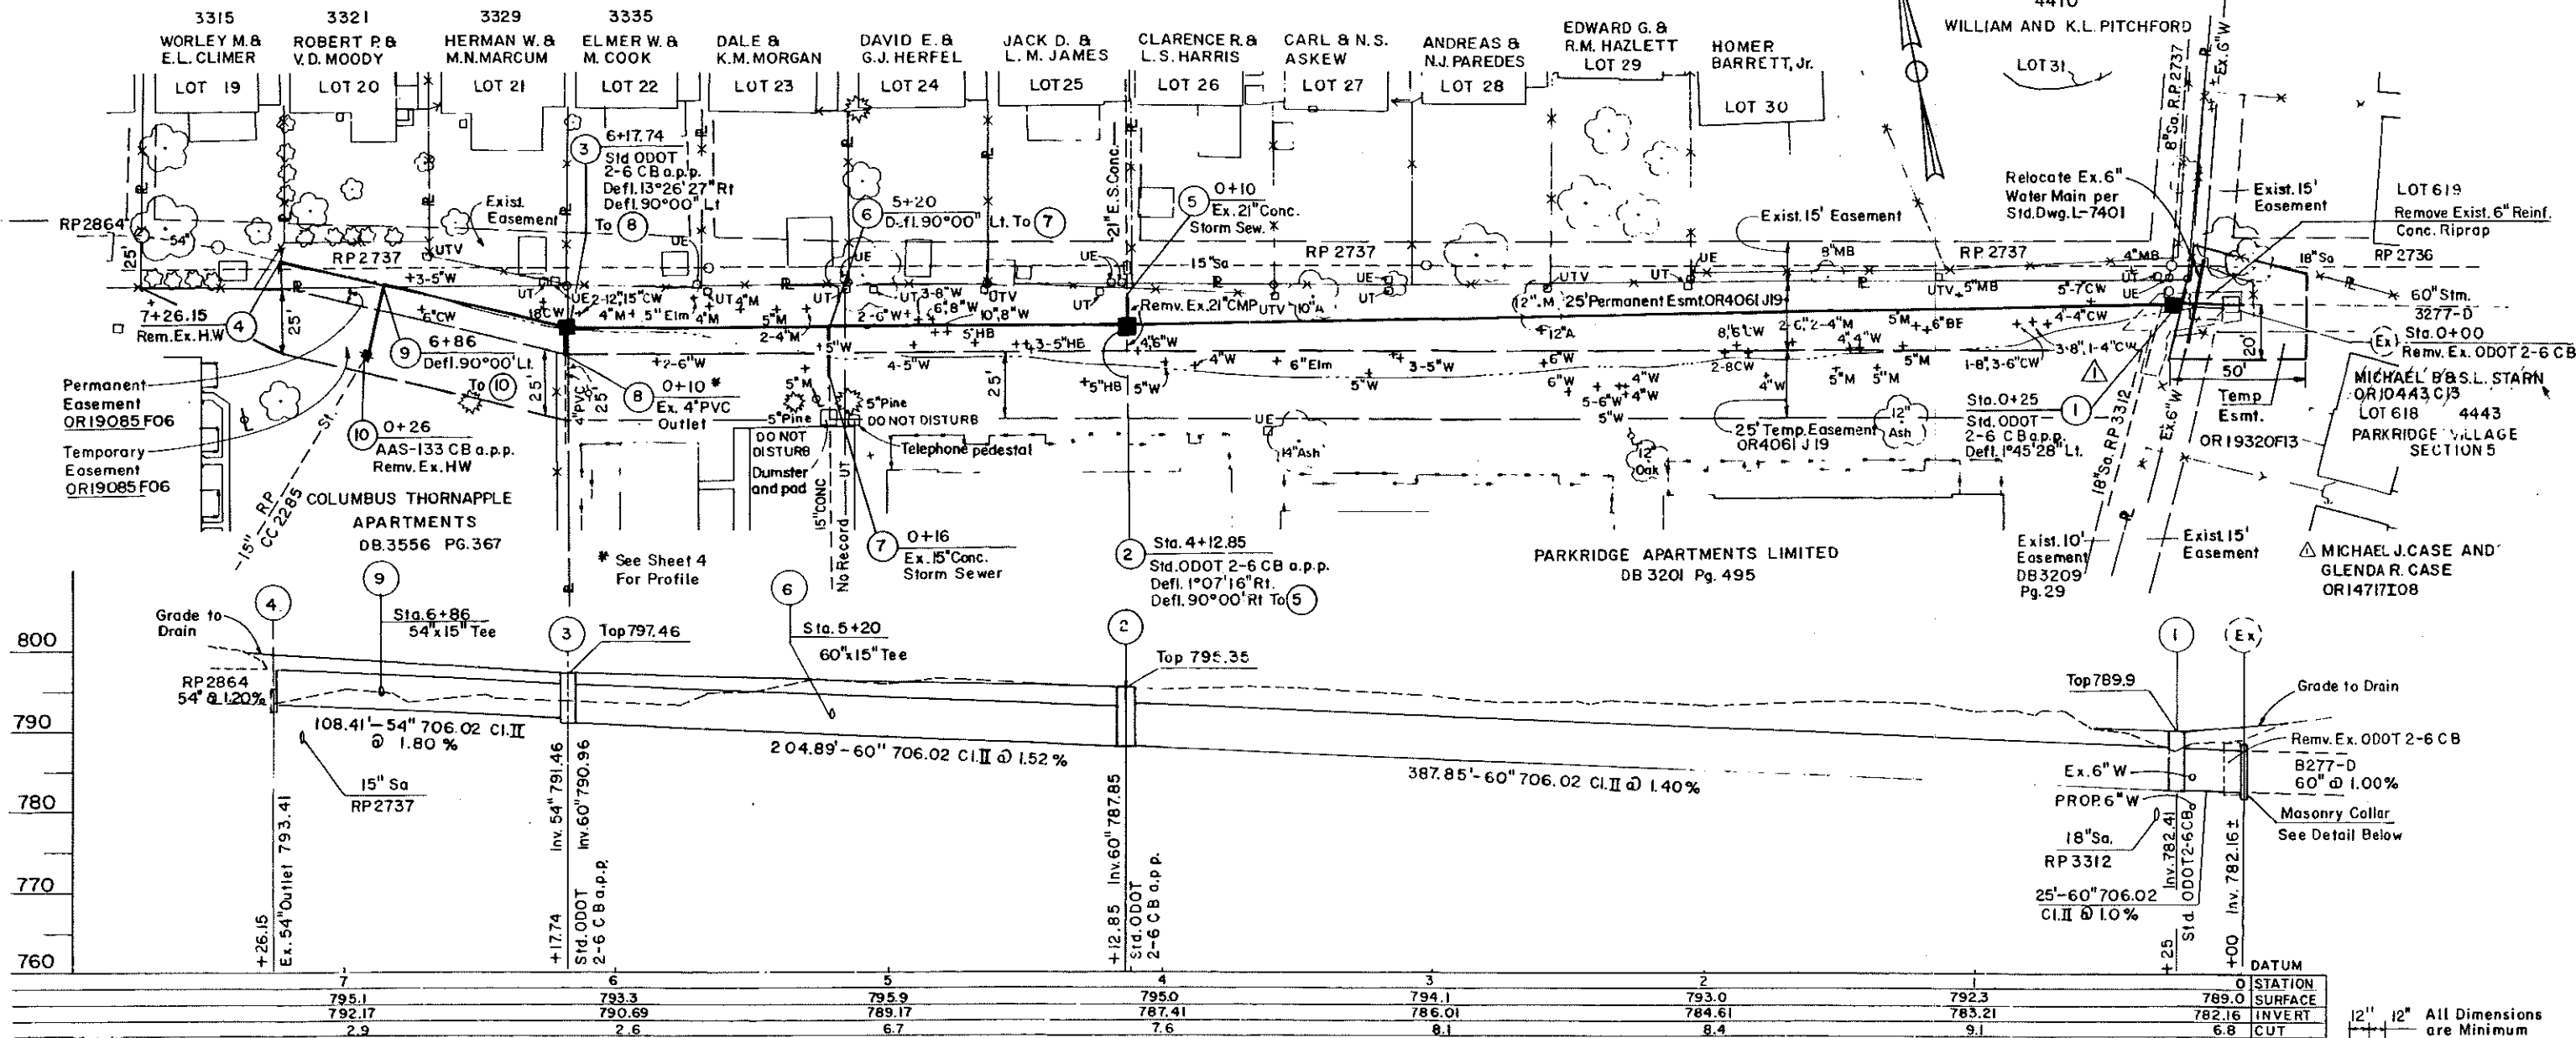

**LEGEND**

- A - APPLE
- BE - BOX ELDER
- CW - COTTONWOOD
- HB - HACKBERRY
- M - MAPLE
- MB - MULBERRY
- W - WILLOW
- UE - UNDERGROUND ELECTRIC PEDESTAL
- UT - UNDERGROUND TELEPHONE PEDESTAL
- UTV - UNDERGROUND CABLE TV PEDESTAL
- o - I.P. FOUND
- a.p.p. - AS PER PLAN

NOTE: Underground Cables run from pedestal to pedestal and are not shown. Expose the Cables prior to Construction.

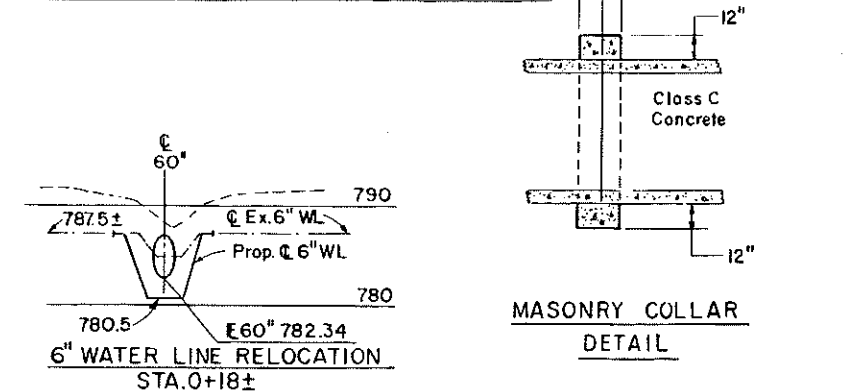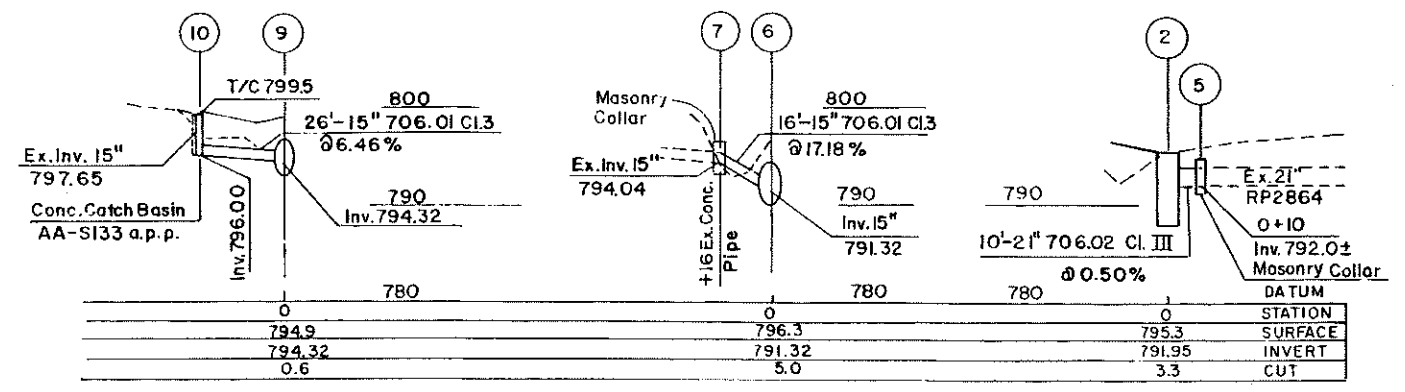


| EASEMENT REFERENCE |                           |         | REVISIONS |   |                            |
|--------------------|---------------------------|---------|-----------|---|----------------------------|
| CITY NO.           | COUNTY RECORDER VOL. PAGE | GRANTOR | NO.       | DESCRIPTION   | APPROVAL/DATE              |
|                    |                           |         | 1         | REVISED TO REFLECT CHANGED EXISTING FIELD CONDITIONS AT C.B. NO.1, NEW PROPERTY OWNERSHIPS, AND ADDED GENERAL NOTES | <i>[Signature]</i> 6/12/92 |

| PROJECT TITLE:                                |     |     |             |  |  |
|---|-----|-----|-------------|--|--|
| PARKLANE AVENUE DITCH ENCLOSURE<br>CIP 710818 |     |     |             |  |  |
| DIVISION USE ONLY                             |     |     |             |  |  |
| OWNER   |     |     | CONTRACTOR  |  |  |
| INSPECTOR                                     |     |     |             |  |  |
| AGREEMENT COMPLETED                           |     |     |             |  |  |
| RPD   | CKD | CID | CON.DR.     |  |  |
| INDEX DETAIL                                  |     |     | RECORD FILE |  |  |

| CITY OF COLUMBUS, OHIO<br>DEPARTMENT OF PUBLIC UTILITIES & AVIATION<br>DIVISION OF SEWERAGE AND DRAINAGE |  |                 |  |
|--|--|-----------------|--|
| DIVISION USE ONLY  |  |                 |  |
| SCALE: HORIZ 1" = 30'<br>VERT 1" = 10'   |  | SHEET 2 / 4     |  |
| CONTRACT DRAWING NO.<br>CC-7390  |  | RECORD PLAN NO. |  |

\* NOTE: The portion of City of Columbus property disturbed during construction shall be restored to its original condition. Cost of Fine Grading and Seeding & Mulching to be included in the price bid for Item 623. Recreation and Mow will need to approve final condition Call 222-7520.

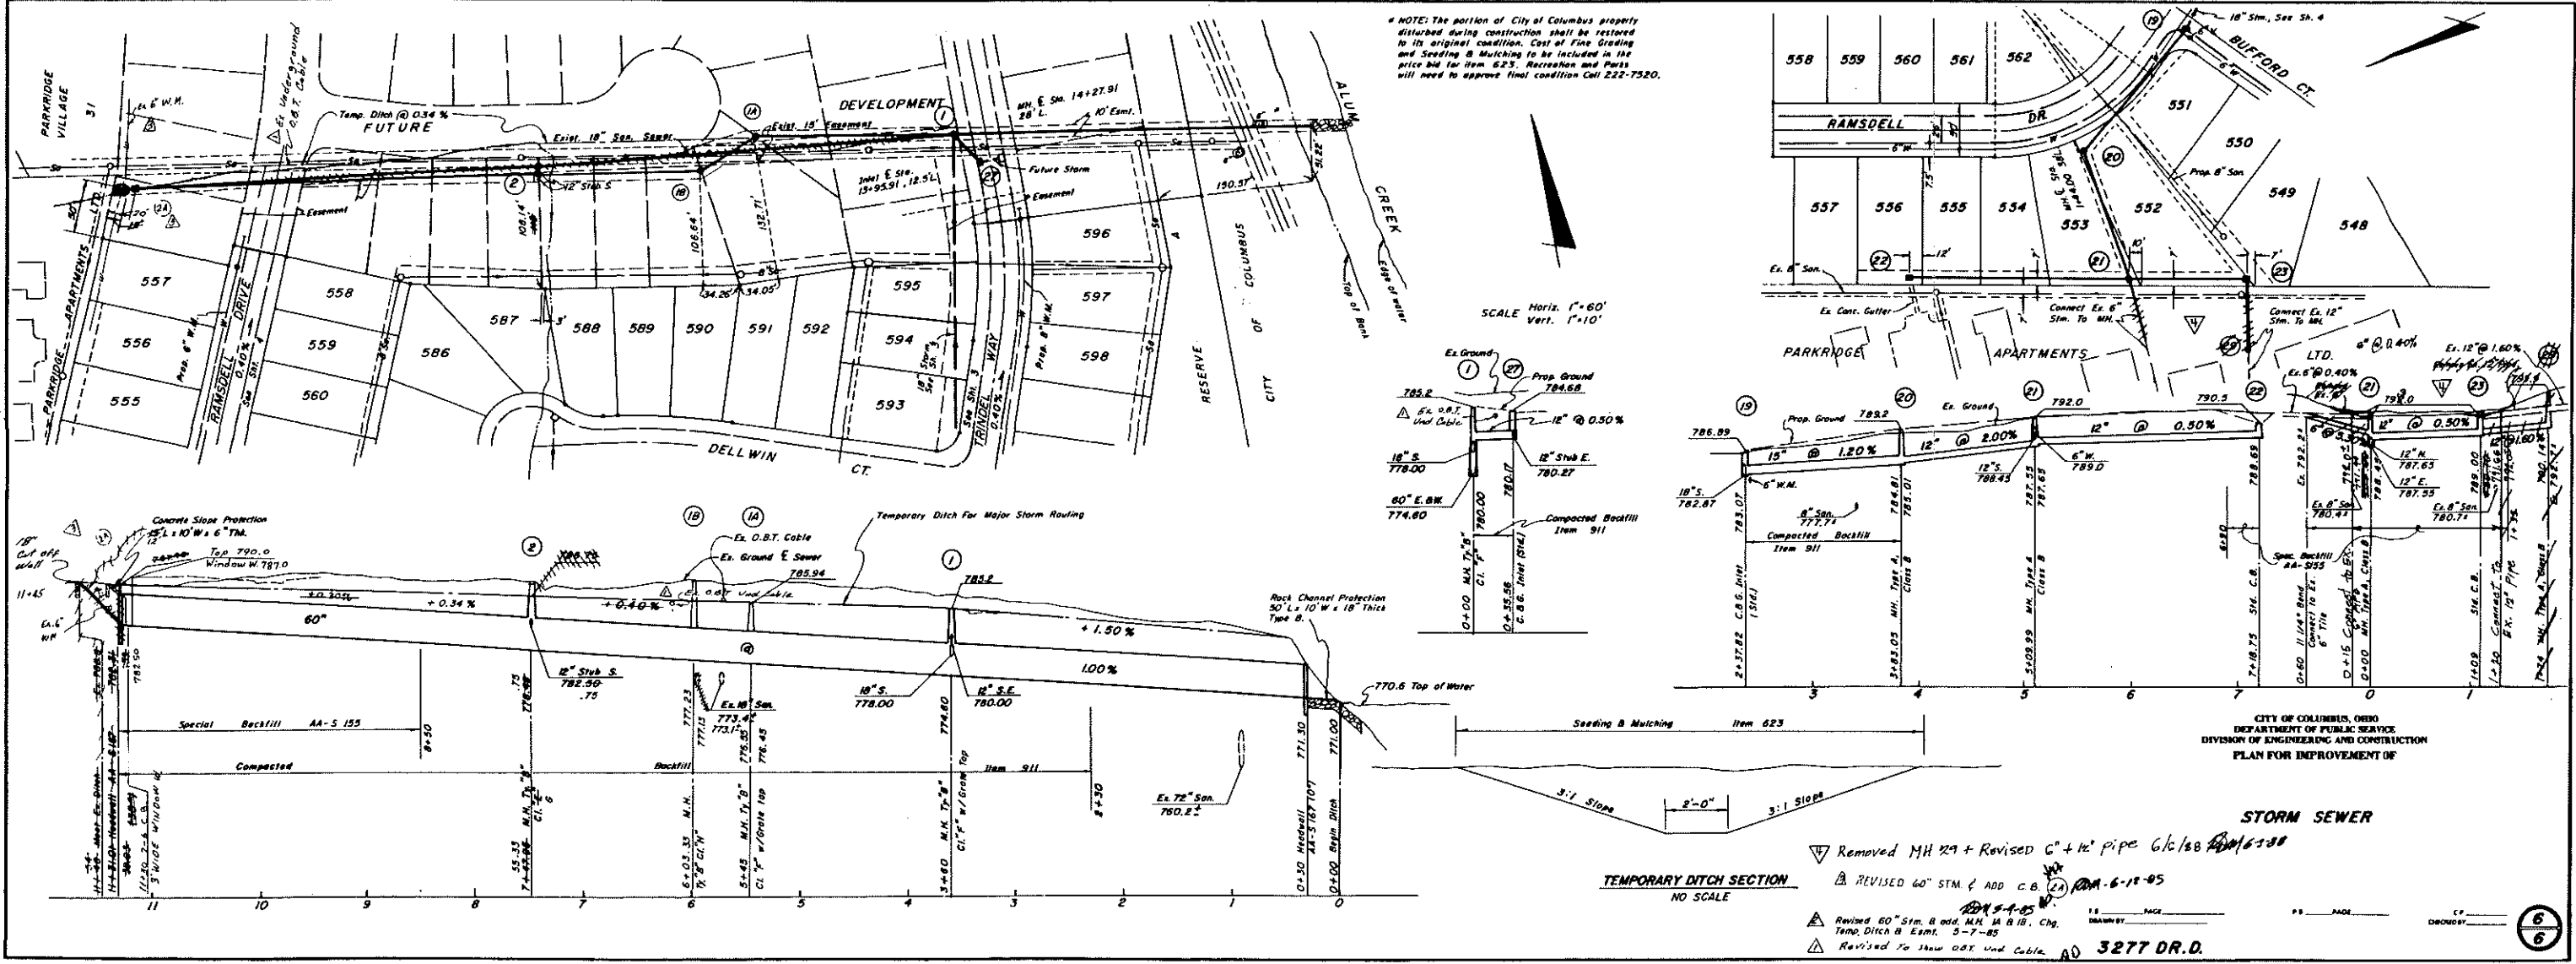

CITY OF COLUMBUS, OHIO  
DEPARTMENT OF PUBLIC SERVICE  
DIVISION OF ENGINEERING AND CONSTRUCTION  
PLAN FOR IMPROVEMENT OF

**STORM SEWER**

Removed MH 29 + Revised 6" + 12" pipe 6/1/88 AD/6538

REVISD 60" STM. & ADD C.B. (2) AD 6-12-85

Revised 60" STM. & add MH 1A B 12. Chg. Temp. Ditch & Exmt. 5-7-85

Revised To Show O&T Und. Cable. AD 3277 DR.D.

TEMPORARY DITCH SECTION  
NO SCALE